


MOBINI, GITA Printed: 8/31/2018 1:44 PM Layout: O-04 E:\PROJECTS\FLORENCE COPPER\CAD\AS-BUILT\OBSERVATION WELLS\129687-011_OBSERVATIONWELL_AS-BUILT.DWG

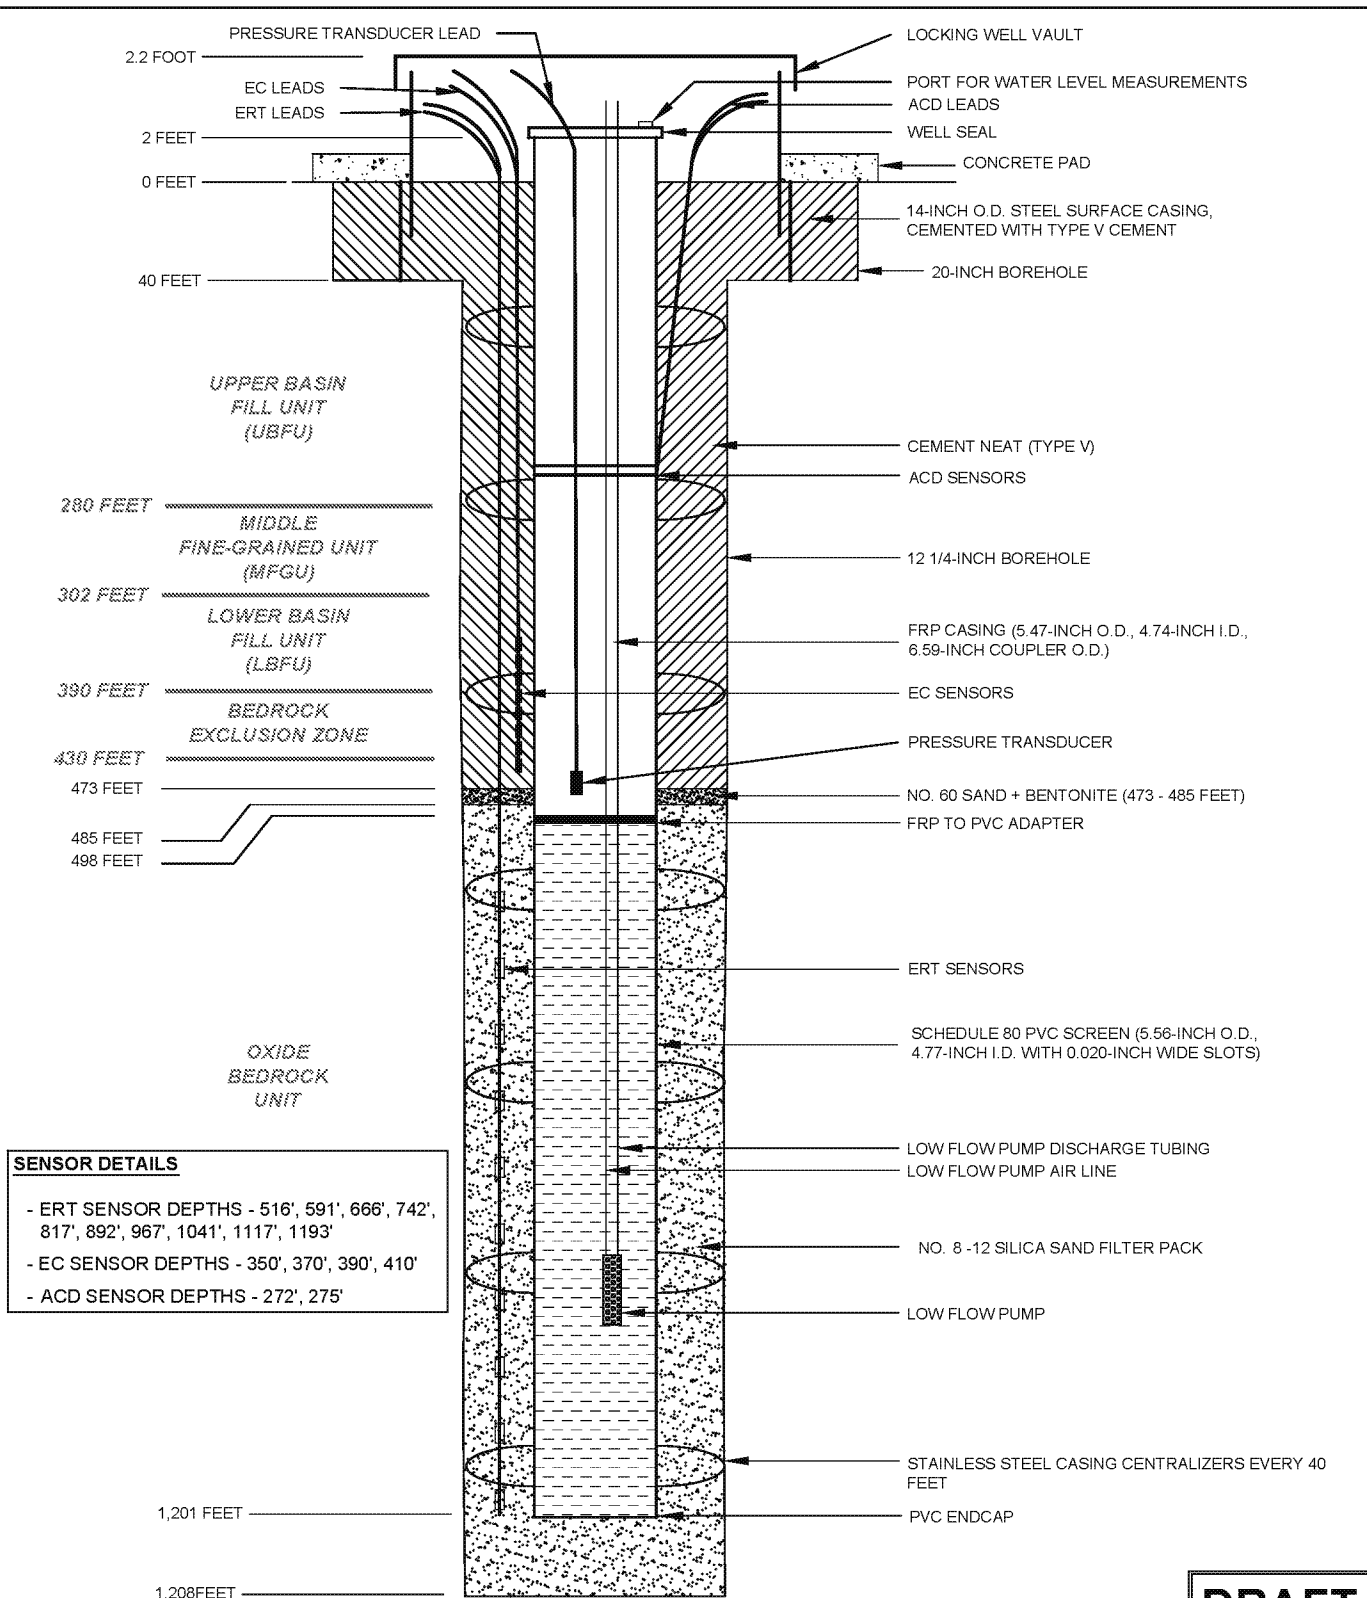

DRAFT

HALEY ALDRICH

PRODUCTION TEST FACILITY
FLORENCE COPPER, INC.
FLORENCE, ARIZONA

O-04 OBSERVATION WELL AS-BUILT DIAGRAM

FLORENCE COPPER

SCALE: NOT TO SCALE
OCTOBER 2017

FIGURE 2

ED_002245_00000104-00001